

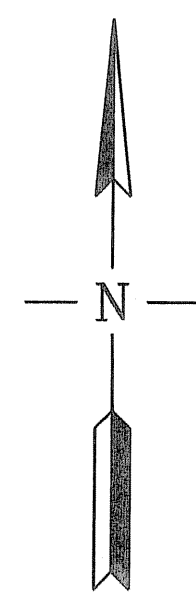


H
G
F
E
D
C
B
A

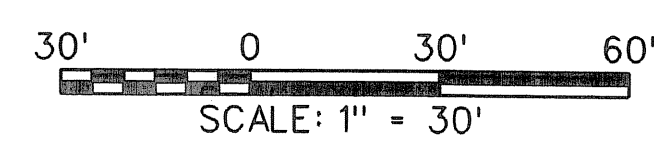

SEE DRAWING
TPA-D-112898-C03

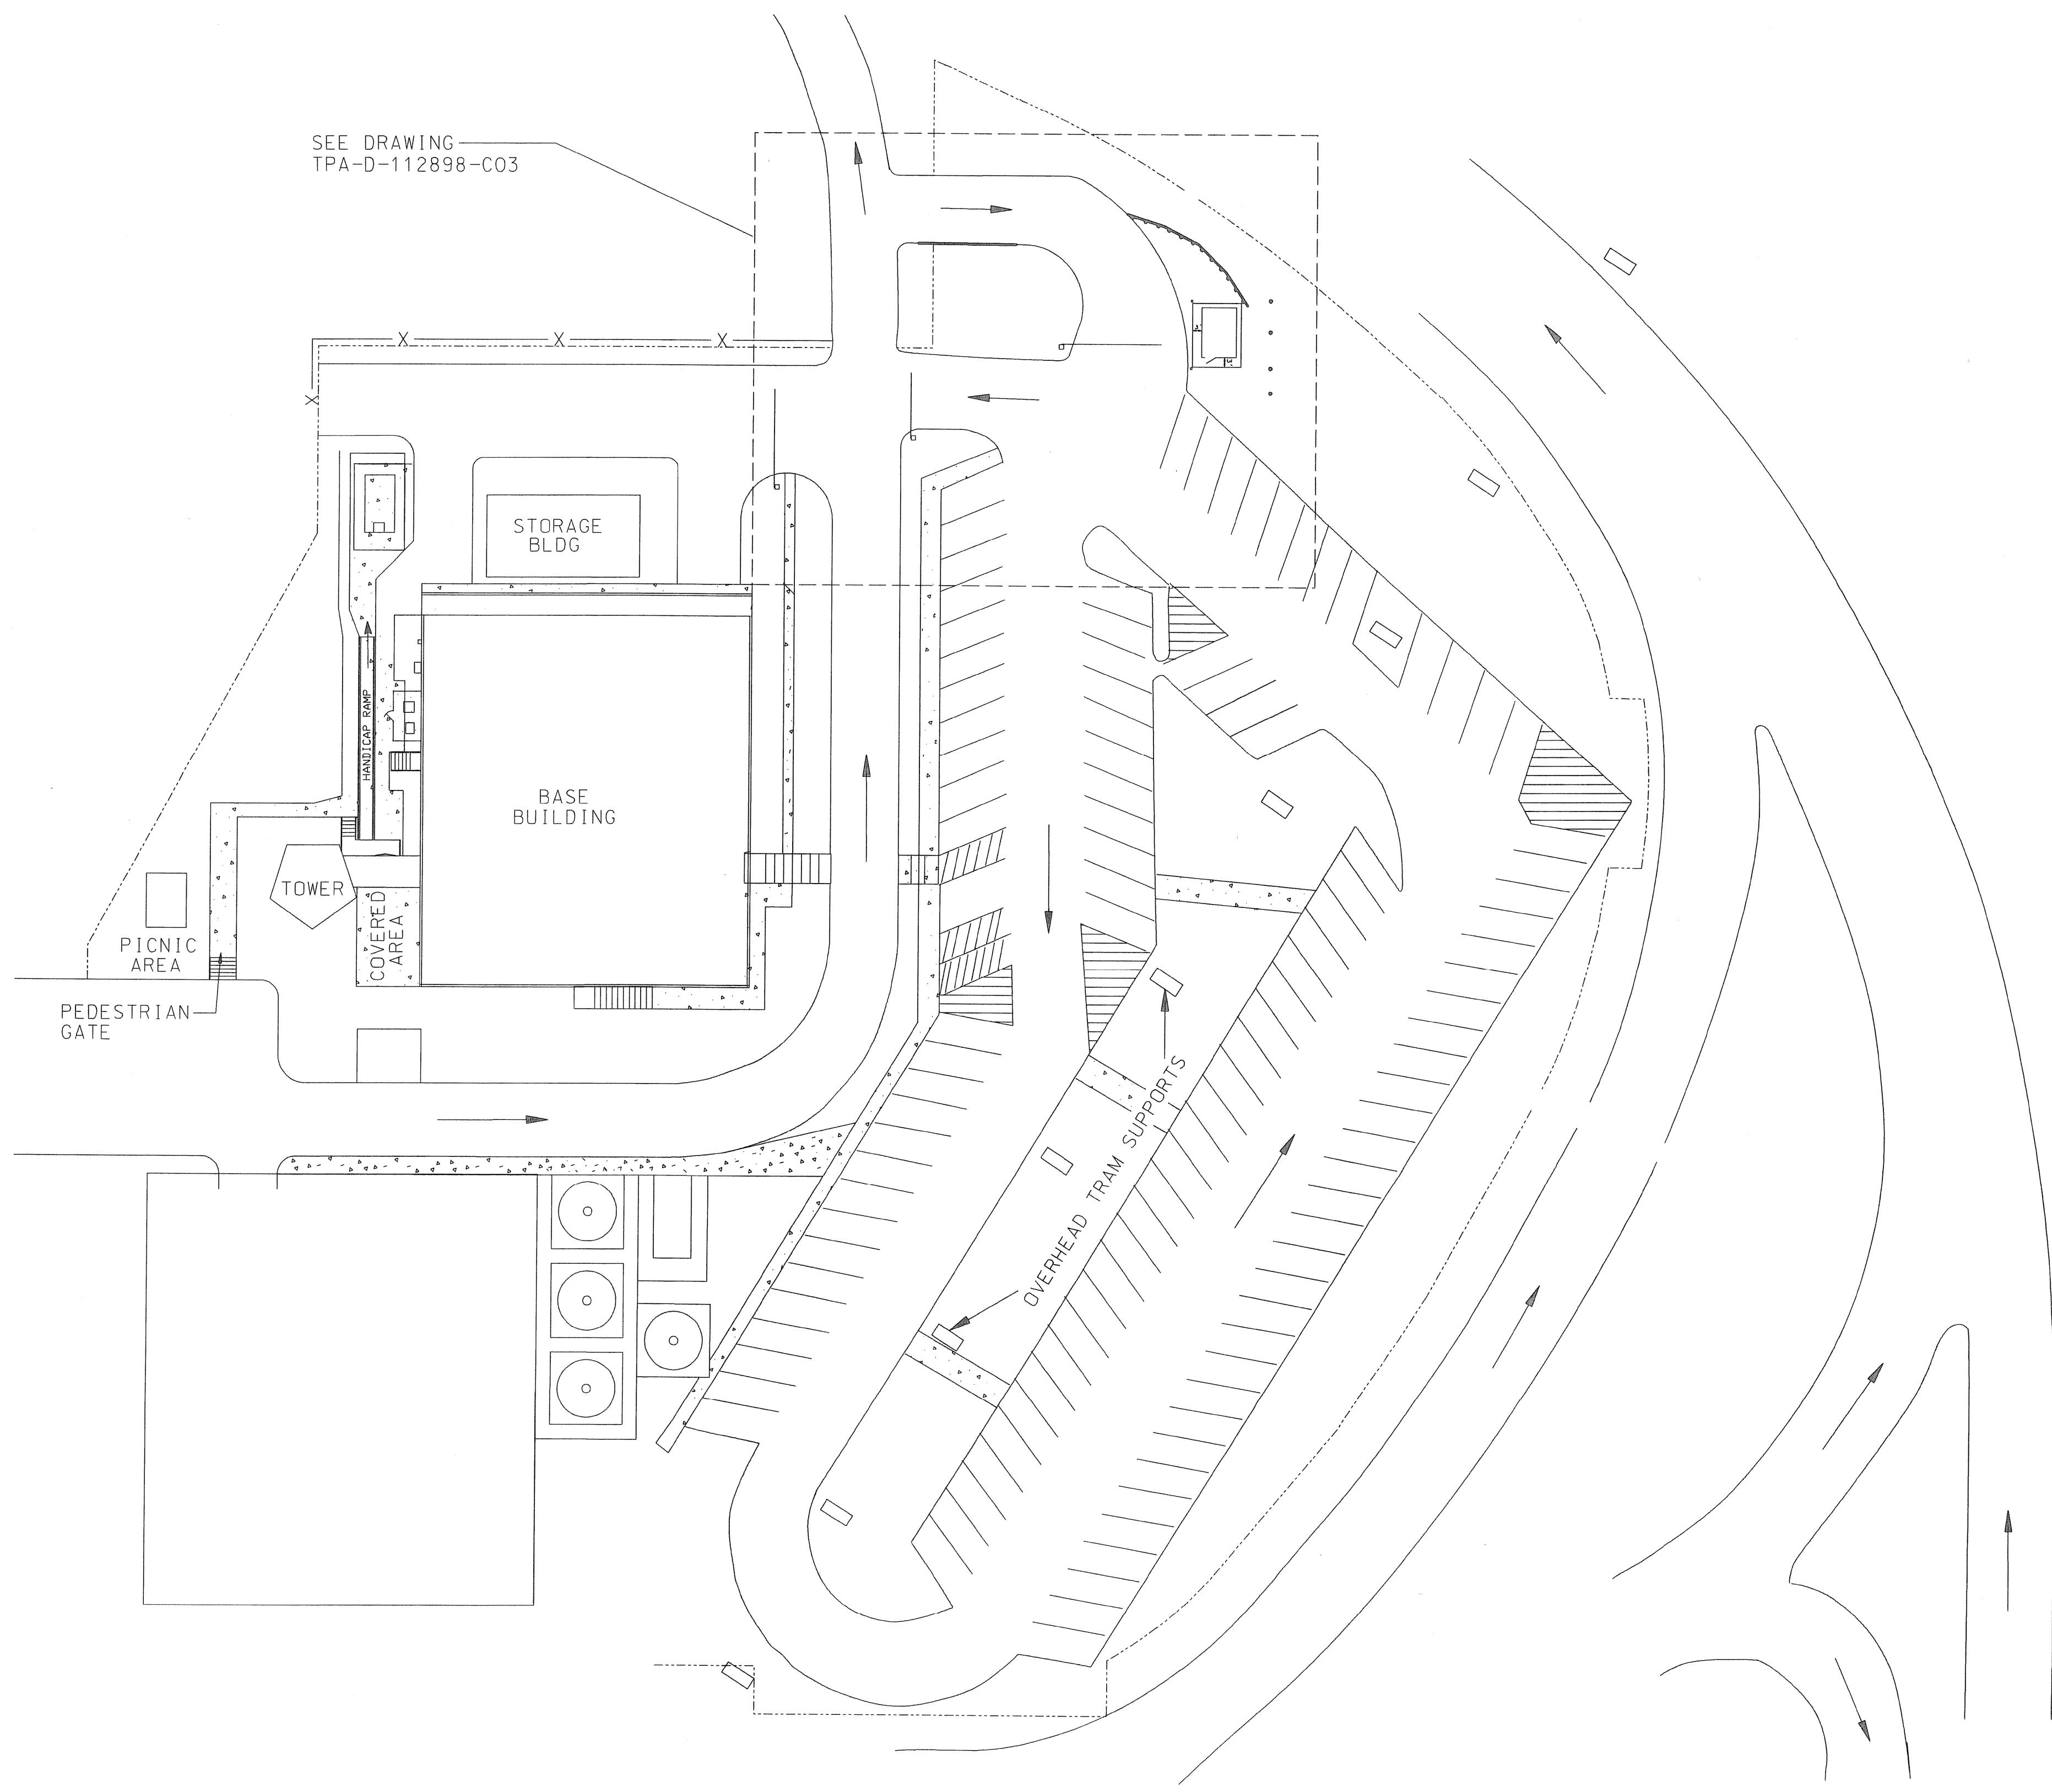

A		03/31/2008		AS-BUILT		MI		112898		03/31/2008		CF	
REV	APPROVED DATE	DESCRIPTION						JCN	REDLINE DATE	APVD			
DEPARTMENT OF TRANSPORTATION FEDERAL AVIATION ADMINISTRATION ATLANTA IMPLEMENTATION CENTER ATLANTA, GA													
ATCT BASE LINE FINAL SITE LAYOUT													
TAMPA				TAMPA INTL AIRPORT				FL					
REVIEWED BY		SUBMITTED BY ORIGINAL DRAWING SIGNED BY:				APPROVED BY ORIGINAL DRAWING SIGNED BY:							
		John M. Herrington				David L. Patrick							
		SR ENGR, INFRASTRUCTURE PLTFRM				MGR, INFRASTRUCTURE PLATFORM							
		DESIGNED MH				ISSUED BY		DATE		JCN		112898	
		DRAWN BH				NAS IMPLEMENTATION		DRAWING NO				REV	
		CHECKED				ANI-300		TPA-D-112898-C02				A	

H
G
F
E
D
C
B
A
ISSUED FOR: AS-BUILT
ED: TPA-D-112898-C02.dgn